

FOR SALE

BRIGHT OFFICE CONDO IN HIGH TRAFFIC AREA

19 Roosevelt Highway, 2nd Floor, Colchester, VT



This 2nd floor office condo is right sized for an up and coming business to purchase an office condo and grow into it over time. Utilize the amount you need and rent the rest! The office condo building sits on .726 +/- acres and is made up of 3 stories. The units are members of the Highpoint Center Area Association, INC. The common area of the association contains 4.18 +/- acres and represents the common land outside of the units.

SIZE:
8,296 SF +/-

ZONING:
Office

PRICE:
\$650,000

AVAILABLE:
Immediately

PARKING:
Ample On-site

LOCATION:
19 Roosevelt Highway, 2nd Floor, Colchester

Information contained herein is believed to be accurate, but is not warranted. This is not a legally binding offer to sell or lease.



For more information, please contact:

JOHN BEAL


802-598-1168

jb@vtcommercial.com

208 FLYNN AVENUE, STUDIO 2i

BURLINGTON, VT 05401

www.vtcommercial.com

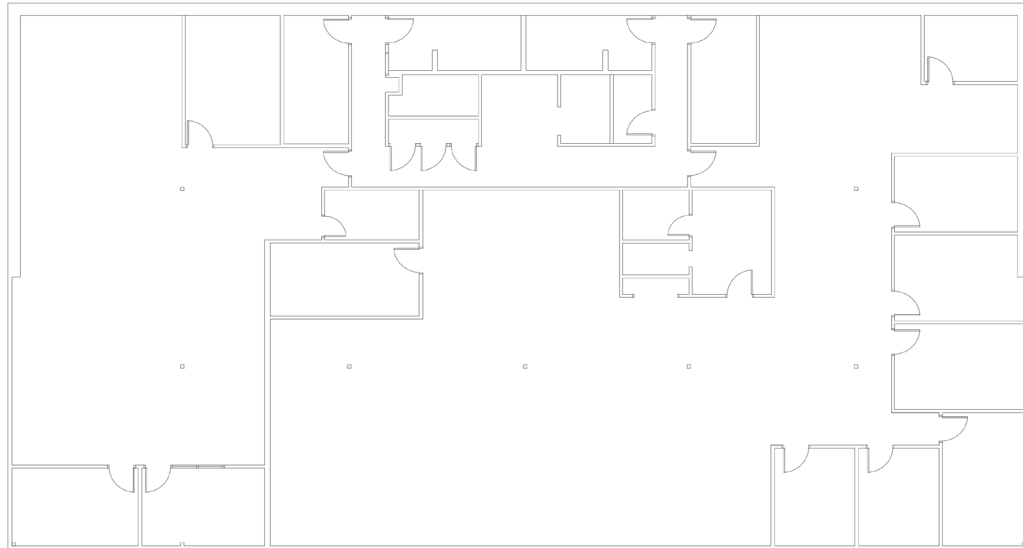

EXISTING SECOND FLOOR PLAN
3/16" = 1'-0"



19 ROOSEVELT HWY ANTELL BUILDING AS BUILTS									
<small>project name:</small> <small>scale:</small> AS NOTED <small>project no:</small> 14-091 <small>checked by:</small> AAR <small>drawn by:</small> AAR <small>date:</small> 02/10/2014	<table border="1"> <thead> <tr> <th>date</th> <th>revisions</th> </tr> </thead> <tbody> <tr> <td> </td> <td> </td> </tr> <tr> <td> </td> <td> </td> </tr> <tr> <td> </td> <td> </td> </tr> </tbody> </table>	date	revisions						
date	revisions								
<small>sheet title:</small> EXISTING SECOND FLOOR PLAN	<small>sheet no.:</small> A1.2								



Vermont Real Estate Commission Mandatory Consumer Disclosure



[This document is not a contract.]

This disclosure must be given to a consumer at the first reasonable opportunity and before discussing confidential information; entering into a brokerage service agreement; or showing a property.

RIGHT NOW YOU ARE NOT A CLIENT

The real estate agent you have contacted is not obligated to keep information you share confidential. ***You should not reveal any confidential information that could harm your bargaining position.***

Vermont law requires all real estate agents to perform basic duties when dealing with a buyer or seller who is not a client. All real estate agents shall:

- Disclose all material facts known to the agent about a property;
- Treat both the buyer and seller honestly and not knowingly give false or misleading information;
- Account for all money and property received from or on behalf of a buyer or seller; and
- Comply with all state and federal laws related to the practice of real estate.

You May Become a Client

You may become a client by entering into a written brokerage service agreement with a real estate brokerage firm. Clients receive the full services of an agent, including:

- Confidentiality, including of bargaining information;
- Promotion of the client's best interests within the limits of the law;
- Advice and counsel; and
- Assistance in negotiations.

You are not required to hire a brokerage firm for the purchase or sale of Vermont real estate. You may represent yourself.

If you engage a brokerage firm, you are responsible for compensating the firm according to the terms of your brokerage service agreement.

Before you hire a brokerage firm, ask for an explanation of the firm's compensation and conflict of interest policies.

Brokerage Firms May Offer NON-DESIGNATED AGENCY or DESIGNATED AGENCY

- **Non-designated agency** brokerage firms owe a duty of loyalty to a client, which is shared by all agents of the firm. No member of the firm may represent a buyer or seller whose interests conflict with yours.
- **Designated agency** brokerage firms appoint a particular agent(s) who owe a duty of loyalty to a client. Your designated agent(s) must keep your confidences and act always according to your interests and lawful instructions; however, other agents of the firm may represent a buyer or seller whose interests conflict with yours.

THE BROKERAGE FIRM NAMED BELOW PRACTICES DESIGNATED AGENCY

I / We Acknowledge Receipt of This Disclosure

This form has been presented to you by:

Printed Name of Consumer

Printed Name of Real Estate Brokerage Firm

Signature of Consumer

Date

Printed Name of Agent Signing Below

[] *Declined to sign*

Printed Name of Consumer

Signature of Agent of the Brokerage Firm

Date

Signature of Consumer

Date

[] *Declined to sign*